

Renew N. $\frac{1}{4}$ 54 T255 R7W

Fd. B.T 25 Recorded in Renewal Nos
24 of 25-7 & 62 of 24-7 25 follows

34" Fir N. 52° E. 30.5 ft.

Turned out - Shows "CS BT" scribe on
unhealed blze.

possible orig. 12" Fir N. 37° E. 15.8 ft

Now shattered stump - no scribe found.

orig. S.E. BT Now turned out stump &
out of position. Set 1" I.P. & BRASS

C&P MKD. COUNTY SURVEYOR'S OFFICE
1966 T245 $\frac{1}{4}$ 54 T255 R7W " & MK.

New BT's -

5" D. Fir S. 63° E. 92.2 ft.

Mkd. $\frac{1}{4}$ 54 CS BT"


14" W. Fir N. 8° E. 64.8 ft.

Mkd. $\frac{1}{4}$ 54 CS BT"

May 13, 1966

V.R.T.
M.S.
J.H.
FILED
RECEIVED

MAY 13 1966

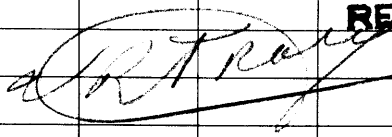

COUNTY SURVEYOR
DOUGLAS COUNTY, ORE.

0

*

C.S. File No. 54/10-7