

Renew $\frac{1}{4}$ $\frac{513}{524}$ T235 R8W

Fd. No Trace of cor. Tree called for.

Ed. o.B.T.'s as follows -

Orig. 18" Now 30" Fir N. 16° W, 9 $\frac{2}{3}$ ft.

2 live - previously opened & face burned.

No scribe fd.

Orig. 20" Now 36" Fir S, 64° W, 33° ft.

Now stump - we open & find " $\frac{1}{4}$ S"

scribe & Reverse, Set 1" I.P. &

BRASS cap MKd. "COUNTY SURVEYORS

OFFICE" 1967 T235 $\frac{1}{4}$ $\frac{513}{524}$

R8W" & MK. New BTs' -

27" D. Fir N. 30° E, 36 $\frac{4}{8}$ ft.

Mkd. " $\frac{1}{4}$ S 13 CS BT"

12" D. Fir S, 27° W, 77 $\frac{3}{8}$ ft.

Mkd. " $\frac{1}{4}$ S 24 CS BT"

This cor. Lies 15 ft. West
of Top of SPUR sloping South.


Feb. 28, 1967

U.R.T.

FILED

J.H.
D.W.

RECEIVED

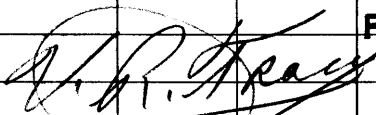

FEB 28 1967

COUNTY SURVEYOR
DOUGLAS COUNTY, ORE.

off 88
* C.S. File No. 54/12-28 on J.W.B.