

Renew: $\frac{1}{4}$ 527 | 526 T235 R8W

Fd. B.T. 25 follows -

orig. 30" Now 44" Fir S. 56° E. 54' ft.
Turned out & lying nearly face down
we open & find "BT" scribe & Reverse.
we use center of stump hole.
Possible orig. N.W. B.T. down & slid
out of position - nearly buried. We
measure from cor. South to creek
195 ft., orig. call is 198 ft. - set
1" I.P. & Brass cap mkd. "COUNTY
SURVEYOR'S OFFICE 1967 T235
 $\frac{1}{4}$ 527 | 526 R8W" & mk. New
B.T.s -

17" D. Fir S. 12° E. 16⁵ ft.

Mkd. " $\frac{1}{4}$ 526 CS BT

11" Cedar N. 62° W. 37⁵ ft.

Mkd. " $\frac{1}{4}$ 527 CS BT"


This cor. lies on SW slope
on new & old N-S. Blazed line.

FILED

Jan 19, 1967

RECEIVED K.R.T.
J.H.

JAN 19 1967

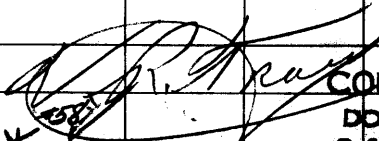

COUNTY SURVEYOR

DOUGLAS COUNTY, ORE.

A.K. JW. B. C.S. File No. 54/12-43