

Review Sec. Cor. <sup>19/20</sup> 30/29 T235 R8W

Fd. B.T.'s as follows -

Orig. 9" Now 15" chinguapin N. 58° E. 14 1/2 ft.

Now snag - scribe '35 8W 20" visible on  
unhealed blaze. - face badly decayed.

Orig. 14" Now 24" chinguapin S. 74° E. 17 1/2 ft.

2 live - shows good scar - cannot open.

Orig. 9" Now 16" chinguapin N. 53° W. 7 1/2 ft.

2 live - blaze never healed - Tree now hollow.

No trace orig. S.W. B.T. - Set 1" I.P.

& BRASS CAP MKD. COUNTY SURVEYOR'S

OFFICE 1967 T235 <sup>519/520</sup> 530/529 R8W "

& MK. New B.T.'s -

5" W. FIR S. 45° E. 7 1/2 ft.

Mkd. " 529 CS BT "

14" chinguapin N. 83° W. 3 1/2 ft.

Mkd. " T235 R8W 519 CS BT "

5" W. FIR N. 45° E. 19 3/4 ft.

Mkd. " 520 CS BT "

6" D. FIR S. 60° W. 23 1/4 ft.

Mkd. " 530 CS BT "

This cor. lies on very steep S.W.  
slope.

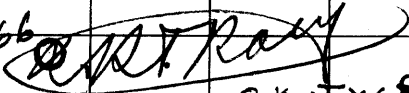
Feb. 1, 1967

VRT

J.H.

D.W.

F.J.

#66  
\* 

O.K. J.W. G.S. File No. 54/12-49