

Renew  $\frac{1}{4}$  S 28 / S 27 T 235 R 8W

Fd. very old squared Post Bally Rotted  
& B.T.'s as follows -

orig. 50" ? Now 50" FIR S. 66° W, 11 2 ft.  
shows old Bark scribe " $\frac{1}{4}$ " & fragmentary  
scribe mks. 2 live -

orig. 50" Now 56" FIR West 2 5 ft.  
shows " $\frac{1}{4}$  S BT" Bark scribe in poor  
cond. - 2 live - set 1" I.P. & Brass cap  
mkd. "COUNTY SURVEYORS OFFICE 1966

T 235  $\frac{1}{4}$  S 28 / S 27 R 8W" at Base of  
orig. B.T. to west & mk. New B.T.s -

5" Hemlock S. 59° E, 7 3 ft  
mkd. " $\frac{1}{4}$  S 27 CS BT"

6" Hemlock S. 30° W, 13 3 ft  
mkd. " $\frac{1}{4}$  S 28 CS BT"

This cor. lies on N.E. slope  
in Heavy Timber approx 150 ft.  
N. of Road course S.W. & N.E.

Dec. 7, 1966


FILED

J.R.T.

RECEIVED

J.H.

D.W.

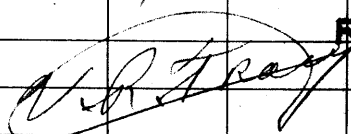

DEC 7 1966

COUNTY SURVEYOR

46  
D.H. J.W.B.

DOUGLAS COUNTY, ORE.

C.S. File No. 54/12-58