

528 | 527

Renew Sec. Cor. 333 | 534 T235 R8W

Fd. B.T.S 25 Follows -

Orig. 36" Now 42" Fir N. 56° E. 11 <sup>2</sup>/<sub>3</sub> ft.  
alive - shows Bark scribe "T235 R8W 527" in  
fair cond.

Orig. 30" Now 40" Fir S. 29° E. 13 <sup>2</sup>/<sub>3</sub> ft.  
alive - shows Bark scribe "T235 534"

we Rescribe "T235 R8W 534 CS BT"

Orig. 24" Now 43" Fir S. 52° W. 36 <sup>3</sup>/<sub>4</sub> ft.  
alive - Bark scribed "T235 R8W 533"

we Rescribe "T235 R8W 533 CS BT"

we find no markings on Perpendicular  
Rock N. 65° W. 28 <sup>1</sup>/<sub>2</sub> ft. Set 1" I.P.


\$ BRASS cap MKD. "COUNTY SURVEYORS  
OFFICE 1966 T235 <sup>528</sup>/<sub>533</sub> | <sup>527</sup>/<sub>534</sub> R8W"

There are no small trees near  
this cor. - cor. lies on very steep  
East slope.

Dec. 7, 1966

V.RIT,  
J.H.  
D.W.

FILED  
RECEIVED

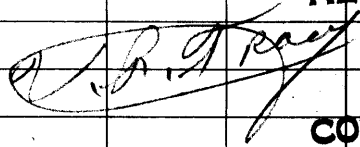

DEC 7 1966

COUNTY SURVEYOR  
DOUGLAS COUNTY, ORE.

X 47 O.K. J.W.R

C.S. File No. 54/12 = 54