

Renew  $\frac{1}{4}$  532  $\frac{1}{4}$  533 T235 R8W

Fd. Sandstone 13" x 8" x 5" MKd. " $\frac{1}{4}$ "

ON W. face firmly set & BTs 25 follow

ORIG. 30" Now 36" FIR S, 8° E. 35 ± ft.

2 live - shows " $\frac{1}{4}$  5 BT" BARK scribe  
in fair cond.

ORIG. 30" Now 36" FIR N, 22° W. 17 ± ft.

2 live - shows good SCAR - we do not open.

set 1" I.P. & BR255 cap MKd. "COUNTY

SURVEYOR'S OFFICE. 1967 T235

$\frac{1}{4}$  532 | 533 R8W" & MK. New BTs -

15" Yew S, 10° W, 41 ± ft,

Mkd. " $\frac{1}{4}$  532 CS BT"

5" Yew N, 69° E, 2  $\frac{7}{8}$  ft,

Mkd. " $\frac{1}{4}$  533 CS BT"


This cor. Lies on steep

West slope approx 200 ft N,

of E.W. cutting line, cutoff to

S.

Jan. 9, 1966

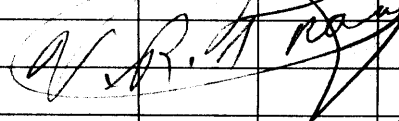

FILED  
RECEIVED  
V.R.T.  
J.H.  
P.W.

JAN 9 1967

COUNTY SURVEYOR  
DOUGLAS COUNTY, ORE.

353  
\* O.K. J.W.B.

C. S. File No. 54-12-52