

Renew $\frac{1}{4}$ S10 / S11 T235 R8W

Fd. B.T.s as follows -

Orig 12" Now " cedar S. 78° E. 57 $\frac{1}{2}$ ft.

alive - shows old scars - we open &

find edges of old axe Blazc &

fragmentary scribe mks. " $\frac{1}{4}$ T "

Orig 30" Fir N. 76° W. 37° ft.

Now Turned out & Badly decayed

No scribe fd. - set 1" I.P. & BR255

cap mks. " COUNTY SURVEYORS

OFFICE 1967 T235 $\frac{1}{4}$ S10 / S11 R8W "

mks. New B.T.s -

7" cedar S. 46° W. 44 $\frac{2}{3}$ ft.

mks. " $\frac{1}{4}$ S10 CS BT "

20" cedar S. 52° E. 22 $\frac{3}{4}$ ft.


mks. " $\frac{1}{4}$ S11 CS BT "

This Lies 66 ft. North of
Small creek course S.W. & on
S.E. slope of point of spur
Ridge.

FILED
RECEIVED

Feb. 9, 1967

U.P.M.
FEB 24, 1967

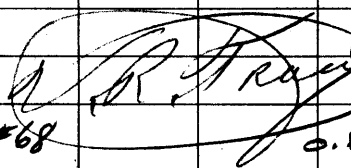

COUNTY SURVEYOR
DOUGLAS COUNTY, ORE.

X#68

C.S. File No. J.W.B. 54/125-56