

Renew  $\frac{1}{4}$  53 | 52 T235 R8W

Fd. Orig. cor. Stone MKd. " $\frac{1}{4}$ " on  
W. face - fell apart in Removal Fd.  
O.B.T.'s as follows -

Orig. 50" Now 55" Fir S. 64° E. 61  $\frac{1}{2}$  ft,  
alive - shows " $\frac{1}{4}$  S" BARK scribe in  
fair cond. Top of Tree gone approx 100 ft hi.

Orig. 12" Now 32" Cedar S. 2° W. 38  $\frac{3}{4}$  ft,  
alive - No scar - We Rescribe

" $\frac{1}{4}$  53 CS BT" - set 1" I.P.

¢ Brass cap in place of Rock  
MKd. "COUNTY SURVEYOR'S OFFICE,  
1967 T235  $\frac{1}{4}$  53 | 52 R8W" & MK

New B.T. -

10" D. Fir S. 28° E. 25  $\frac{3}{4}$  ft,  
MKd. " $\frac{1}{4}$  52 CS BT"

This cor. Lies on steep south  
slope 20 ft. north of small  
creek, course S. 70° E. Put pieces  
of cor. stone in brass cap hole.

March 6, 1967


FILED

U.R.T.

RECEIVED

J.H.

D.W.

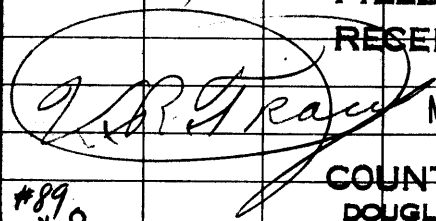

MAR 6 1967

COUNTY SURVEYOR

DOUGLAS COUNTY, ORE

C. S. File No. 54/12-59

#89

X<sup>o</sup>

O.K. J.W.B.