

Review N.W. Cor. Sec. 6 T235 R8W
Fd. 1963 C.S. BR355 (See Rev. #21) &
BTS as follows -

O.B.T.-40" FIR STUMP N. 40° W, 27[±] ft,
Rescribed "T235 R8W S6 CS BT" decaying
Badly.

9" Now 12" D. FIR S. 70° E. 56[±] ft,
2 live-scribe visible on nearly healed blaze.
we MK. New BTS -


4" D. FIR N. 49° E. 26[±] ft,
MKd. "CS BT"

4" D. FIR N. 21° W. 115[±] ft.
MKd. "CS BT"

This cor. lies approx. 300 ft. west
of Top of spur Ridge on moderate
west slope

Feb. 20, 1967

V.R.T.
J.H.
D.W.

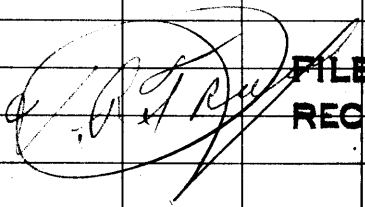

FILED
RECEIVED

FEB 20 1967

COUNTY SURVEYOR
DOUGLAS COUNTY, ORE.

76-19W
#10
* 21

O.K. J.W.B.

C.S. File No. 54/12-65