

Renew $\frac{1}{4}$ 59/510 T233 R8W

Fd o.B.T.s 25 follows -

ORIG. 50" Now 58" FIR N. 30° E. 7 $\frac{3}{4}$ ft.

2 live - BARK scribe " $\frac{1}{4}$ BT" in fair cond.

ORIG. 36" Now 46" FIR S. 72° W. 21 $\frac{1}{2}$ ft.

2 live - BARK scribe " $\frac{1}{4}$ S BT" in fair cond.

Set 1" I.P. & Brass cap MKd. "COUNTY

SURVEYOR'S OFFICE 1967 T235 $\frac{1}{4}$ 59/510

R8W" & MK. New B.T.s -

9" Hemlock N. 75° W. 21 $\frac{6}{8}$ ft.

Mkd. " $\frac{1}{4}$ S 9.05 BT"

7" Hemlock N. 64° E. 34 $\frac{3}{4}$ ft.

Mkd. " $\frac{1}{4}$ S 10.05 BT"

This cor. lies on S. slope approx


50 ft N. of small creek course E.

line N. of cor. To Top of Ridge is

Bench like & moderate in ascent.

May 8, 1967

V.R.T.
J.H.
D.W.

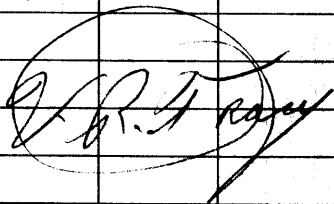

#94

X

O.K.

S. H. NO. 54/12-66