

Renew $\frac{1}{4}$ $\frac{519}{530}$ T235 R8W

Fd. orig. cor. stone in place & mkd.
with "X & $\frac{1}{4}$ " & O.B.T.S as follows -

orig. 20" now 28" Hemlock N69°E, 12 $\frac{1}{2}$ ft,
Down & "4" scribe visible on open
blaze.

orig. 14" now 26" cedar S, 48°E, 24 $\frac{1}{2}$ ft,
Now SN29 - shows scar - don't open,

set 1" I.P. & BRASS cap mkd. "COUNTY
SURVEYORS OFFICE 1967 T235

$\frac{1}{4}$ $\frac{519}{530}$ R8W" & Reset Rock along
side - MARK NEW B.T.S -

7" Hemlock S, 9°W, 10 $\frac{1}{2}$ ft,

mkd. " $\frac{1}{4}$ 530 CS BT"


16" cedar N, 2°W, 49 $\frac{1}{2}$ ft,

mkd. " $\frac{1}{4}$ 519 CS BT"

This cor. lies on N.E. slope
of SPUR sloping N.

OCT 24, 1967

V.R.T.
J.H.
V.R.

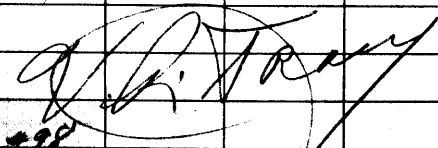

0 O.K. J.W.B.

C.S. No. 54/12-69