

Renew <sup>58/59</sup> 517/516 T215 R5W

Ed. Haines "T" IRON at COR. point  
& B.T. Recorded in Renewal # 33 -  
36" D. FIR N. 17° W. 40<sup>±</sup> FT.

Shows "T215 R5W S8 BT" BARK SCRIBE  
& Haines Button on face. Also find BT -  
ORIG. 18" NOW 48" FIR (STAMP) S. 17° W. 40<sup>±</sup> FT.  
No scribe visible on new face - we open  
higher on stamp & find "S 17" scribe.  
we find NO TRACE other ORIG. BTs -  
MARK NEW BTs -

7" D. FIR N. 47° E. 7<sup>±</sup> FT.

Mkd. "T215 R5W S9 CS BT"

8" D. FIR S. 86° E. 19<sup>±</sup> FT.

Mkd. "T215 R5W S16 CS BT"


7" D. FIR S. 32° W. 14<sup>±</sup> FT.

Mkd. "T215 R5W S17 CS BT"

August 16, 1965

URT  
M.D.  
M.S.  
T.C.

FILED  
RECEIVED

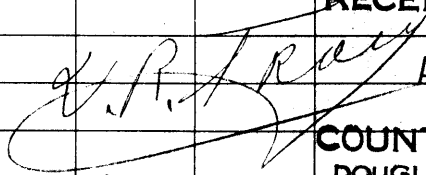

AUG 16 1965

COUNTY SURVEYOR  
DOUGLAS COUNTY, ORE.

Y X <sup>2125</sup>

C. S. File No. 54/14-12