

Renew Sec. COR. of <sup>29</sup>/<sub>32</sub> <sup>28</sup>/<sub>33</sub> T215 R6W

Fd. C.S. Brass Cap & B.T.s 25 follows-

Note: See Rev. #70 -

orig. Now 24" Fir S. 31° E. 19° ft.

only live o.B.T. - scribe visible on open Blaze

N.W. o.B.T. Now Dead. N.E. C.S. B.T. Now dead.

C.S. 12" Fir S. 54 1/2° W. 22 1/2 ft.

2 live - Blazes nearly healed. - we

Mk. New B.T.s -

6" D. Fir N. 70° W. 20 1/2 ft.

Mkd. T215 R6W S 29 C.S. BT "

8" D. Fir S. 78° E. 19 1/2 ft.

Mkd. T215 R6W S 33 C.S. BT "

8" D. Fir N. 25° E. 71 1/2 ft.


Mkd. T215 R6W S 28 C.S. BT "

This COR. lies on Top of Ridge  
course N. 30° E. - S. 30° W.

April 3, 1967

URT  
J.H.  
D.W.

FILED  
RECEIVED

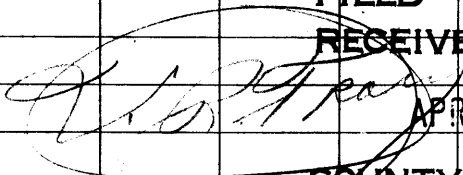

APR 3 1967

COUNTY SURVEYOR  
DOUGLAS COUNTY, ORE.

#123

\*O

D.K. J.W.B.

C.S. File No. 54/14-19