

Renew Sec. Cor ^{55/54} 58/59 T215 R4W

Fd. Sandstone 10" x 10" x 18" Firmly
Set, Recorded as Basalt in Ren. #90

also Weyerhaeuser Method B.T.s alive & in
good cond. also orig B.T. as follows -

Orig. 12" Now 16" FIR S. 12° E. 11 ²/₃ ft.

Fragmentary Scribe on upper scar now
burned - "BT" scribe visible on previously
opened lower scar. Set 1" I.P. & Brass

cap MKd. "COUNTY SURVEYOR'S OFFICE

1966 T215 ^{55/54} 58/59 R4W" & MK Existing

Weyerhaeuser B.T.s -

6" D. FIR S. 29° E. 9 ¹/₂ ft.

Mkd. "T215 R4W 59 CS BT"

12" D. FIR N. 27° E. 32 ²/₃ ft.

Mkd. "T215 R4W 54 CS BT"

9" D. FIR N. 6° W. 21 ³/₄ ft.

Mkd. "T215 R4W 55 CS BT"


8" Laurel S. 47° W. 26 ⁴/₈ ft.

Mkd. "T215 R4W 58 CS BT"

July 26, 1966

V.R.T.
J.B.
J.H.

Tom Watts - BLM.

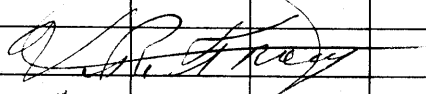

* ~~78~~

O.K. J.W.B.

C.S. File No. 55/14-25