

Renew  $\frac{1}{4}$  57 + 58 T235 R4W

Fd. Haines "T" Iron Recorded in Ren. # 46

and BTs as follows -

orig. 30" now 36" Pine S. 36° E. 11 $\frac{3}{4}$  ft.

Bark scribed " $\frac{1}{4}$  5" 2 live.

orig 36" now 40" Fir S. 14° W 27 $\frac{3}{4}$  ft.

Bark scribed " $\frac{1}{4}$  5 BT" 2 live.

Because these BTs are good saw logs we mark new BTs -

8" W. Fir N. 59° E 16 $\frac{3}{4}$  ft.

Mkd " $\frac{1}{4}$  58 CS BT"

8" D. Fir S. 26° W 43 $\frac{3}{4}$  ft.

Mkd. " $\frac{1}{4}$  57 CS BT"

This cor. lies approx 150° ft

East of Ridge top course N.W. on


Edge of change from Rolling top to

steep East slope.

OCT 26, 1965

FILED U.R.T.  
M.S.  
RECEIVED

OCT 26 1965

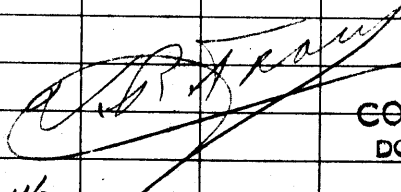

COUNTY SURVEYOR  
DOUGLAS COUNTY, OR.

#116

+ X

C. S. File No. 54/16-12