

SEARCH FOR $\frac{1}{4}$ $\frac{22}{27}$ T235 R4W ✓

Fd. $\frac{3}{4}$ " I. PIPE FOR COR. - 66"

FIR STUMP N. 25° E. 292 ft.

No scribe fd - matches Bearing & Dist. for orig. B.T. No TRACE orig. S.W. B.T. -


20" D. FIR S. 77° E. 144 ft.

Find axe face - NOT scribed - Numerous CRUISER'S MARKS.

I.P. lies 90 ft N. of FIRE TRAIL course E & W.

NOV. 8, 1965

V.R.T.
M.S.
J.L.

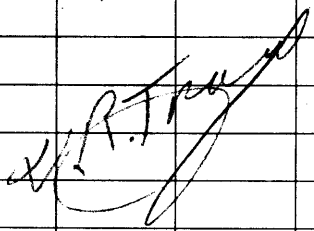

FILED
RECEIVED

NOV 8 1965

COUNTY SURVEYOR
DOUGLAS COUNTY, ORE.

✓

C. S. File No. 54/16-17