

Renew  $\frac{1}{4}$   $\frac{536 T225}{51 T233 R400}$

Fd. 1" I.P. & 1" ALUM. PIPE AND STUMPS  
of BTs recorded in Rev. # 43 - NOT  
scribed - "W" Nails ONLY - WE MARK  
NEW BTs -


10" Hemlock N. 61° W. 683 ft.  
MKd "  $\frac{1}{4}$  S 36 DCS BT "

7" Hemlock S. 7° E. 581 ft.  
MKd "  $\frac{1}{4}$  S 1 DCS BT "

This COR. IS ON LAKE - DOUGLAS  
Co. Line.

NOV. 4, 1965

V.B.T.  
M.S.  
J.L.

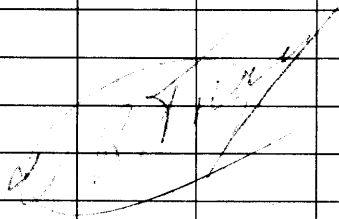

FILED  
RECEIVED

NOV 3 1965

COUNTY SURVEYOR  
DOUGLAS COUNTY, ORE.

$\frac{120-22-T}{4116-72-T}$

+ \*

C. S. File No. 54/16-37