

KENESH $\frac{16}{21} \frac{15}{22}$

T235 RFW

Rem. #2


FOUND - GEARED AXLE AT COR.

36" NOW 42" FIR 534°W 126.7

SHOWS GOOD BARK SCRIBING WE

ALSO FIND STUMP OF NE BT NW

BT NOT FOUND

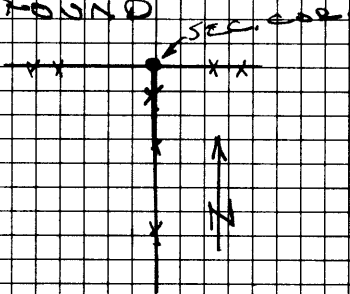

NEW BTS.

RESURVEY NOW 42" R. FIR 534°W 126.7

ADDED "C S BT" IN WOOD.

14" W. OAK BEARS N14°W 498

SCRIBED 5/6 T 235 RFW C S BT

16" B. OAK BEARS N21°E 545

SCRIBED 5/5 T 235 RFW C S BT.

NO TREES NEAR TO SE

OCT 28 - 1965

J. W. S.
M. S.
S. E.

#112

+ * -

C.S. File No. 54/16-47