

Renew Sec. Cor. 532 | 533 T235
55 | 54 T245 R3W

Fd. 1950 G20 Brass cap firmly set
& properly MKd. & B.T. as follows -

8" Now 16" Hemlock N. $53\frac{1}{4}^{\circ}$ E, 19⁸ ft.

2 live - scribe MKs. visible on unhealed blaze

8" Now 14" Hemlock S. $18\frac{1}{4}^{\circ}$ E, 20⁵ ft.

2 live - healed blaze

12" Hemlock S $70^{\circ}45'$ E, 37⁰ ft.

Now stump - scribe MKs visible,

18" Yew N. $49\frac{1}{2}^{\circ}$ W, 64⁰ ft.

Now stump - scribe MKs visible.

ORIG. FIR TO S.W. NOW STUMP - we
find NO BARK scribe - NO TRACE ORIG

B.T. TO S.E. as called for, we MK.

New B.Ts -

8" Hemlock S. 38⁰ W, 18⁴ ft.

Mkd. "T245 R3W 55 CS BT"

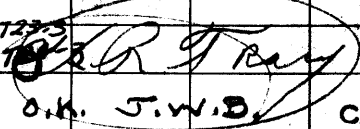
9" Chinquapin N. 34⁰ W, 12⁸ ft.

Mkd. "T235 R3W 532 CS BT"

This cor. lies 150 ft. N. of
small creek (dry) in cut off area.

Sept. 25, 1967

V.R.T.
J.H.

463-1225
466-1225


O.K. J.W.D.

C.S. File No. 54/16-53