


COUNTY SURVEYORS FILE DATA  
DO NOT REMOVE FROM OFFICE

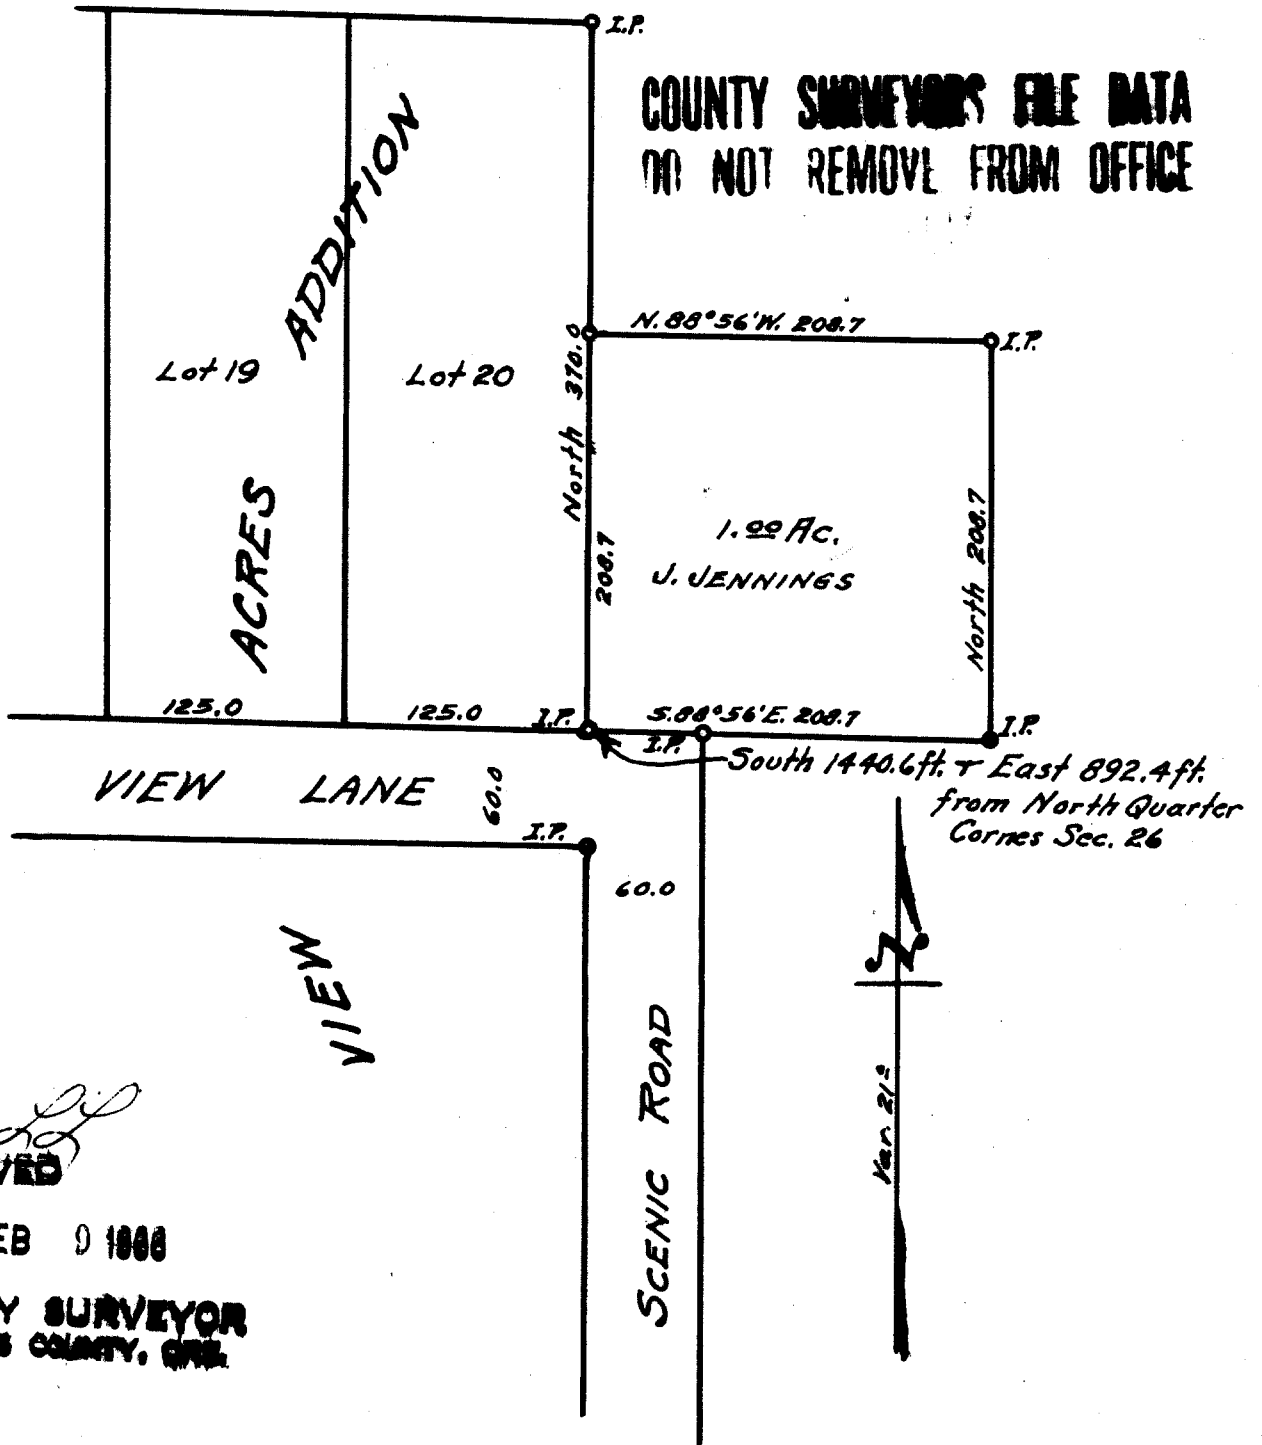

FILED  
RECEIVED

FEB 9 1966

COUNTY SURVEYOR  
DOUGLAS COUNTY, OREG.

COUNTY SURVEYOR'S OFFICE  
DOUGLAS COUNTY, OREGON.

SURVEY FOR

R. K. JENNINGS

IN SECTION 26, T. 30 S., R. 3 W., W.M.

GEO. J. WENDEROTH, DEPUTY. FEB. 1966

SCALE 1" = 100 ft.

REGISTERED  
OREGON  
LAND SURVEYOR

*Geo. J. Wenderoth*

MARCH 10, 1944  
George J. Wenderoth  
5

C. S. File No. 44-11