

517/516

Renew Sec. Cor. 520/521 T205 R7W

Fd. ONE Remaining B.T. 25 Follows -

Orig. 24" Now 50" Fir N. 8° E. 26 1/2 ft.

we open & find "S1" scribe under  
70 to 75 years growth. appears That Tree  
will Live. Badly burned. No Trace  
of Rock called for or other B.Ts

Set 1" I.P. & BRASS cap MKd. COUNTY

SURVEYOR'S OFFICE 1966 T205

517/516  
520/521 R7W" & MK. New B.Ts -

11" D. Fir N. 6° E. 8 1/2 ft.

Mkd. T205 R7W 516 CS BT"

9" D. Fir S. 9° W. 21 6/8 ft.

Mkd. T205 R7W 521 CS BT"

15" Maple S. 30° E. 8° ft.

Mkd. T205 R7W 520 CS BT"

20" D. Fir N. 25° W. 70° ft.

Mkd. T205 R7W 517 CS BT"

COR. LIES ON VERY STEEP WEST  
SLOPE. IN OXBOG BURN.

Sept 6, 1966

V.R.T.


J.B.

J.H.

Jim R66

FRANK YOUNG

BLM.

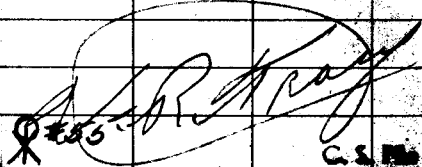

C.S. No. 54/22-5