

Renew Sec. Cor. ⁵¹⁸ 519 | ⁵¹⁷ 520 T205 R7W

Fd. Haines "T" IRON 2^d cor. of STUMPS of
B.T.S as follows - (See Ren. #8)

Orig. 36" Now 43" FIR S, 52° E, 53 ⁵/₈ ft.
Now Burned Stump - Shows faint SCR.
we do not open.

Orig 36" Now 48" FIR S, 14° W. 17 ³/₈ ft.
Recorded as S. 26° W. - we open & find
scribe MKs. No TRACE NE, & NW, B.T.'s
at point of intersection of distances
from Remaining B.T.'s - set 1" I.P. &
BRASS Cap MKd. "COUNTY SURVEYORS
OFFICE 1966 T205 ⁵¹⁸ 519 | ⁵¹⁷ 520 R7W"

Reset "T" along side BRASS cap & set
Red Steel fence post along side.
No Live Trees available for B.T.s - we
Rescribe ORIGINALS -

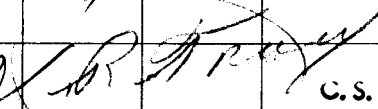
48" FIR (STUMP) S, 14° W, 17 ³/₈ ft.
MKd. "T205 R7W S 19 CS BT"

43" FIR (STUMP) S 52° E, 53 ⁵/₈ ft.
MKd. "T205 R7W S 20 CS BT"

This Cor. Lies on very Steep
N. Slope on E.-W. Cutting Line.

Sept 21, 1966

V.R.T.
J.H.

⁵⁵⁹
*09 

C.S. File No. 54/22-9