

Renew S.E. COR. D.L.C. #43 T265 R7W

Fd. ONLY ORIG. B.T. 25 follows -

ORIG. 8" Now 19" B. O2K, N. 10° W, 14⁵ Ft.

We open & find "C 43 265" scribe

at COR. point. set 1" I.P. & BRASS COP

6" in the ground & Build mound of Stone

24" high around Pipe. BRASS COP MKd.

"COUNTY SURVEYORS OFFICE 1966

T265 S.E. COR. — D.L.C. 43 R7W"

& MK New BTs -

9" D. FIR N. 81° W, 18° Ft.

Mkd. "S.E. D.L.C. 43 CS BT"


16" D. FIR S. 74° E, 31⁹ Ft.

Mkd. "S.E. D.L.C. 43 CS BT"

This COR. Lies on Steep N. Slope.

March 14, 1966

U.R.T.
M.S.
J.H.

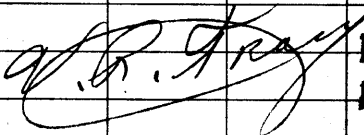

**FILED
RECEIVED**

MAR 14 1966

**COUNTY SURVEYOR
DOUGLAS COUNTY, ORE.**

*#69

C.S. File No. 54/23-12