


Renew N.N.E. COR. D.L.C. #43 T265 R7W
Fd. Rock 10" x 6" x 20" Firmly set at very
old fence cor. & Remnants of old oak
Post & 1/2" I.R. set in top of post as
Recorded in Ren #19-2250 fence cor.
Bears West 26° ft from Rock. to perpetuate
Boyers Ren. We set 1" I.R. & BRASS cap
along side of Rock MKD. COUNTY SURVEYOR'S
OFFICE 1966 T265 NNE. COR. T D L C
43 R7W " & MK New B.T. -
7" B. oak N 73 ° E. 135³ ft.
MKD. NNE. D L C 43 C S B T
COR. lies at fence cor. fence N. & W.
26° ft E. of fence cor. fence W. E. & S.

March 14, 1966

V.R.T.
M.S.
J.H.

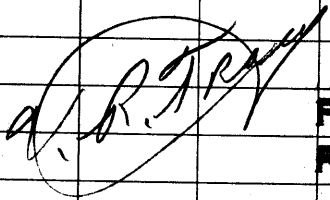

**FILED
RECEIVED**

MAR 14 1966

**COUNTY SURVEYOR
DOUGLAS COUNTY, ORE.**

* #70

54/23-13