

Renew $\frac{11}{4 \ 20}$ T265 R7W

Fd. one B.T. 25 follows -

ORIG. 60" Now 72" FIR S. 20 W. 11³ ft

ORIG. field notes call for 6" FIR. we

find very old BARK scribe " $\frac{1}{4}$ 5" &

faced area now burned at base of tree

where BT would have been. we open

& find ring count reveals approx. 6"

of growth. No trace of Laurel to NW.

Set 1" I.P. & BRASS CAP MKD. "COUNTY

SURVEYORS OFFICE 1966 T265

$\frac{1}{4}$ $\frac{517}{320}$ R7W " & MK NEW BT'S -

15" D. FIR S. 67° W. 27^L ft.

MKD. " $\frac{1}{4}$ 5 20 CS BT"

8" W. FIR N. 33° W. 29^O ft.

MKD. " $\frac{1}{4}$ 5 17 CS BT"


COR. Lies 20 ft N. of old Log Road

Cutoff to South of Line

May 10, 1966

FILED
RECEIVED

U.R.T.
M.S.
J.H.

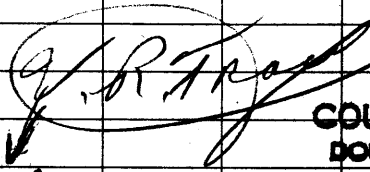

MAY 10 1966

COUNTY SURVEYOR
DOUGLAS COUNTY, ORE.

479
*

O. K. J. W. B.

C. S. File No. 54/23-23