

Renewal #162

55/536

T275 R7W

Found:

Brass cap set for W.T. Cor MKD.

County Surveyors office

T275 R7W

W.C. 60' East to

535/536

1969

20" Maple

569 E

175³

Scribe visible

W.C. $\frac{1}{4}$ 536 to 87

$\frac{3}{4}$ " I Rod

579 W

133⁴

at Base of Pole 1-918

1 $\frac{1}{4}$ " x 1" I Bar

588 E

90¹

Northerly cor of House

520 E

6²

I leave W.T. Cor set for Bearing object.

Renewal

Set Brass cap at $\frac{1}{4}$ cor MKD.

County Surveyors office

T275 R7W

$\frac{1}{4}$

535/536

1971

Bearing objects for $\frac{1}{4}$ cor.

$\frac{5}{8}$ " I Rod

N 29 W

60³

3 $\frac{1}{2}$ " I P.R.

N 31 $\frac{1}{2}$ E

57²

(1 $\frac{1}{4}$ " IRON BAR

S 79¹ E

307¹)

SEE RENEWAL #41


[Signature]
#175

10.12.71 - over.

C. S. File No. 54/23-37

DIETZGEN NO. 385-6

5" IRod at base of
tele. Pole 2-948
579W-133L

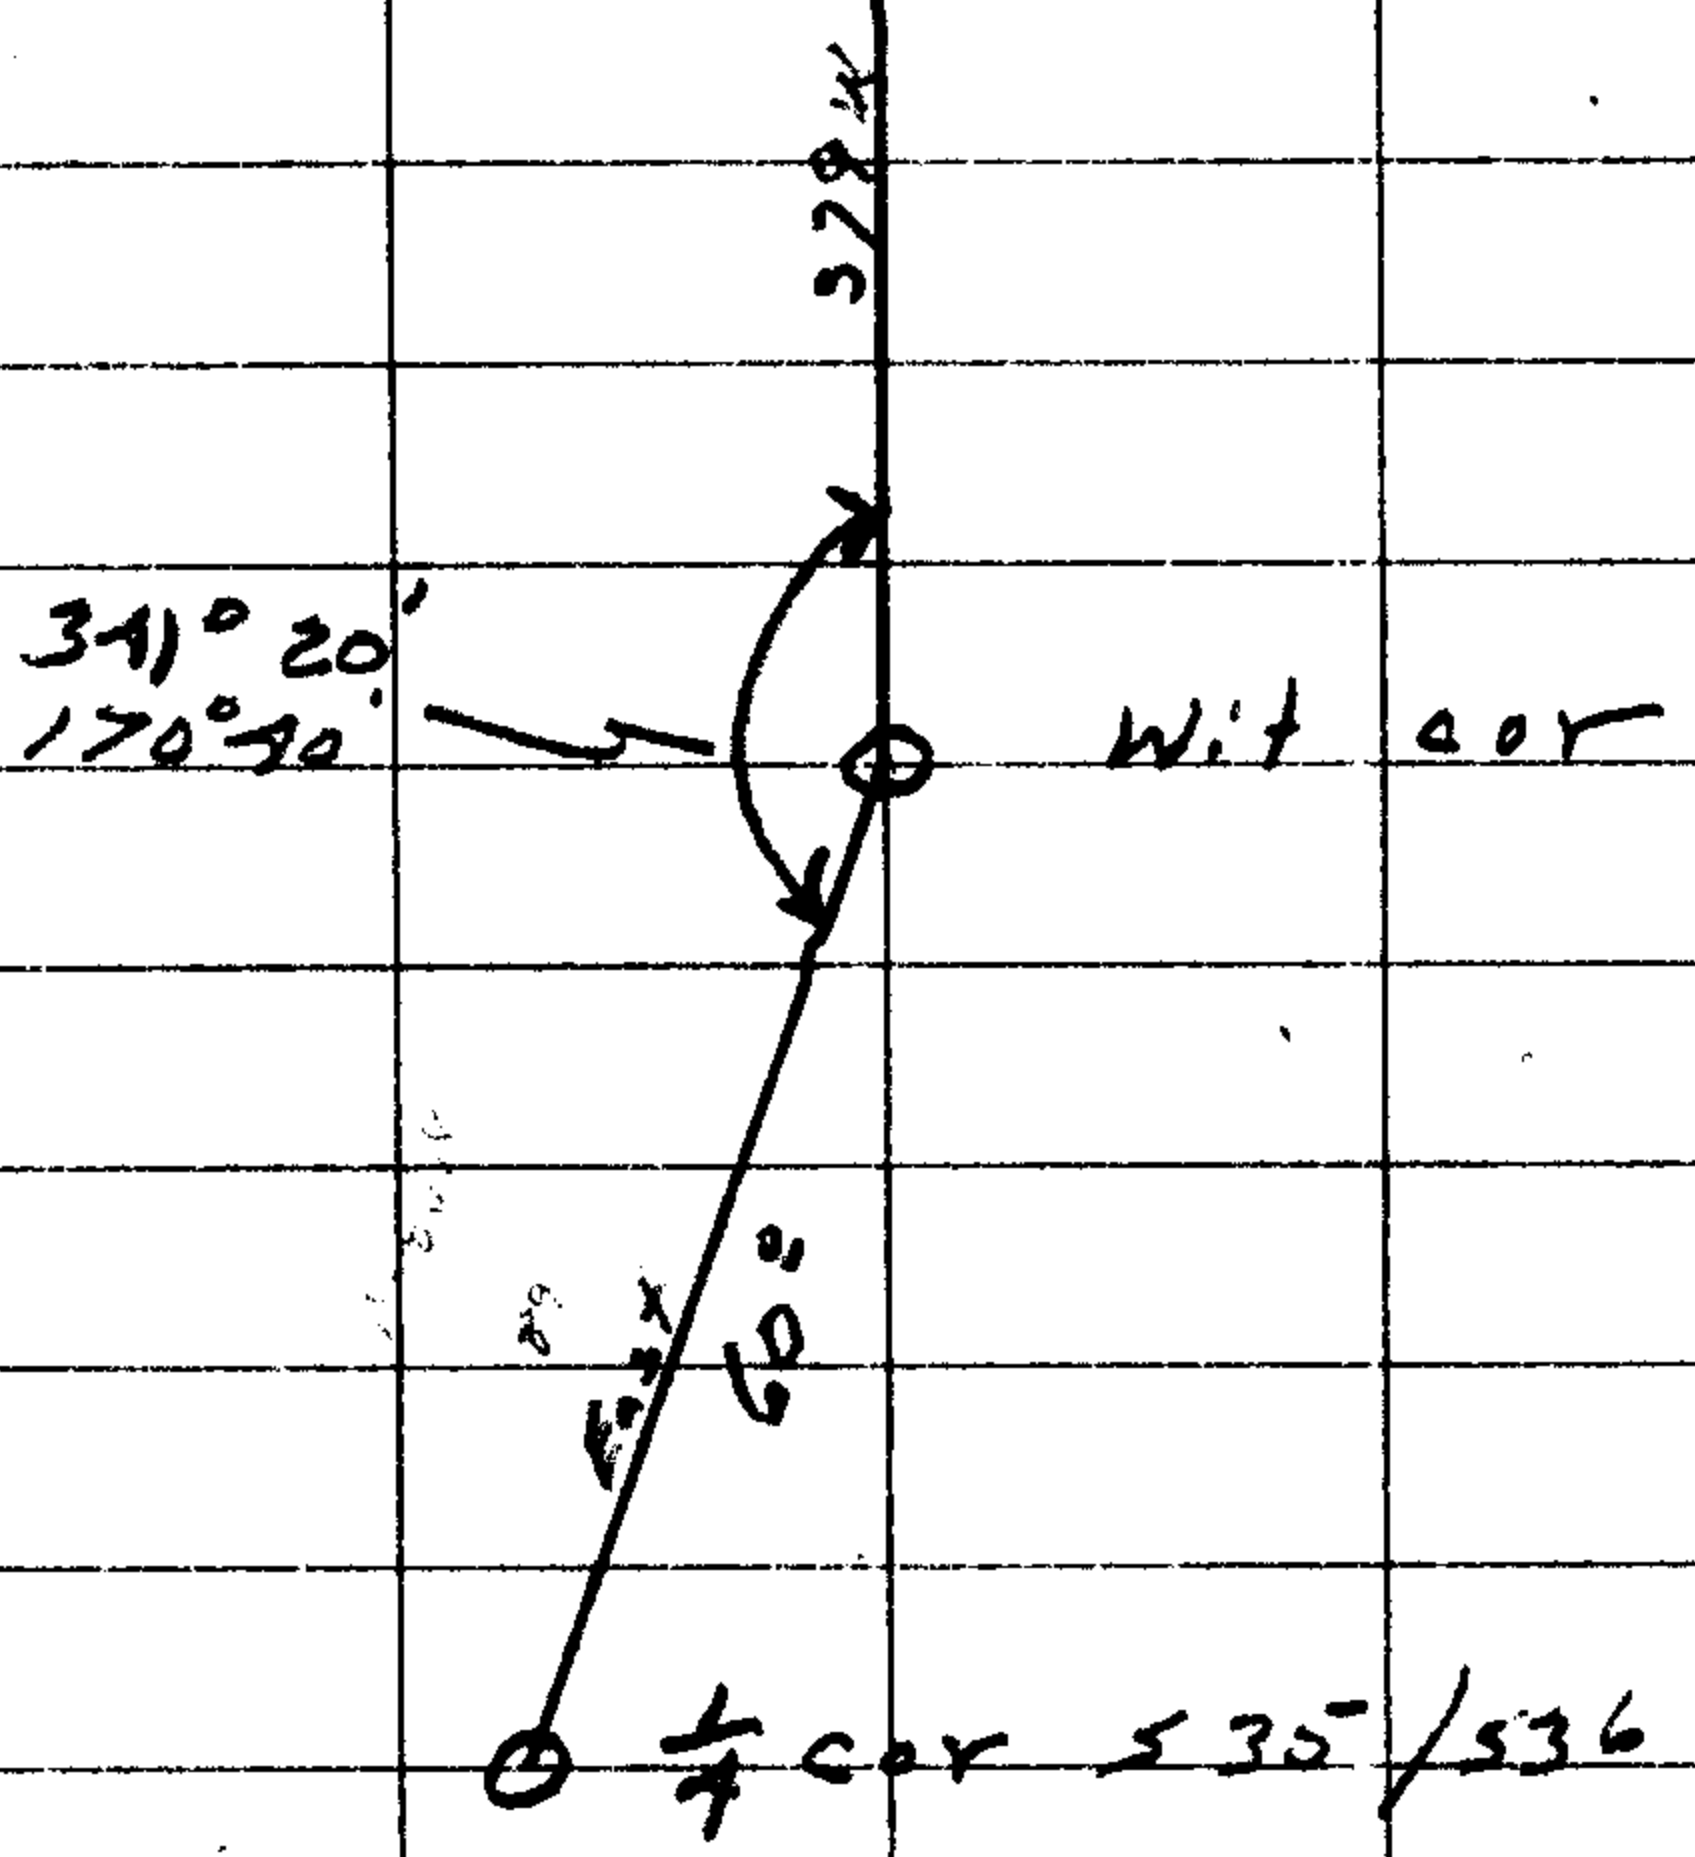

Notes

This cor lies under 2x" Man Hole cover which lies in front of looking glass store in E of county rd.

0.4
5.1
1.1
1.3