

Renew $\frac{1}{4}$ 528 + 527 T255 R3w

Fd. GLO. BRASS cap MKd." $\frac{1}{4}$ 528 | 527

1943" & 1943 Resurvey B.T.s as follows -

48" Fir S. 42° E. 42 $\frac{1}{2}$ ft.

Now STUMP & TURNED out, No scribe fd.

42" Now 46" Fir S. 44° W. 38 $\frac{1}{2}$ ft.

Now stump - FRAGMENTARY scribe visible on partially healed blaze.

We MK. New B.T.s -

5" Hemlock S. 33° E. 27 $\frac{1}{2}$ ft

Mkd." $\frac{1}{4}$ 527 CS BT"


5" Red Cedar N. 86° W. 47 $\frac{1}{2}$ ft.

Mkd." $\frac{1}{4}$ 528 CS BT"

This cor. Lies approx. 200 ft. N. ORTH of small creek course East. 2/50 BRASS cap in middle of small Blow down Hemlock.

July 12, 1966

FILED V.R.T.
J.H.
RECEIVED

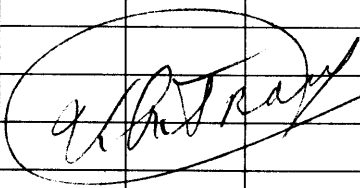

JUL 12 1966

COUNTY SURVEYOR
DOUGLAS COUNTY, ORE.

1270
* O.K. J.W.B.

C.S.F. No. 54/27-26