

Renew $\frac{1}{4}$ 529 | 528 T25 S R3W

Fd. G.L.P. BRASS Cap. MKd." $\frac{1}{4}$ 529 | 528 1943"

& B.T's as follows -

ORIG. 1883 48" Now 50" FIR S. 71 $\frac{1}{2}$ ° E, 25 $\frac{1}{2}$ ft.

shows old BARK scribe " $\frac{1}{4}$ 528 BT" now STUMP.

ORIG. 60" FIR N. 54 ° W, 11 $\frac{3}{4}$ ft.

Turned out & Badly Broken up. Fragmentary
BARK scribe fd.

1943 Resurvey 22" Now 24" FIR S. 84 $\frac{1}{2}$ ° E, 29 $\frac{1}{2}$ ft.

shows " $\frac{1}{4}$ 528 BT" on unhealed Blaze - Now STUMP

1943 Resurvey 32" FIR S. 5 ° W, 41 $\frac{6}{8}$ ft.

Now STUMP - No scribe fd. we MK. New
BT's -

24" D. FIR S. 30 ° W, 63 $\frac{6}{8}$ ft.

Mkd." $\frac{1}{4}$ 529 CS BT"

26" D. FIR N. 38 $\frac{1}{2}$ ° W, 84 $\frac{1}{2}$ ft.

Mkd." $\frac{1}{4}$ 529 CS BT"


NO TREES available in Sec. 28
COR. Lies on N.-S. cutting line
cutoff to East.

FILED

RECEIVED

July 11, 1966

JUL 11 1966
V.R.T.

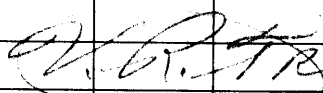

COUNTY SURVEYOR
DOUGLAS COUNTY, ORE.

#71
O.K. J.W.B.

C.S. File No. 54/27-27