

Renew $\frac{1}{4}$ $\frac{520}{529}$ T255 R3W

Fd. G.T.O. BRASS Cap MKd. " $\frac{1}{4}$ $\frac{520}{529}$ 1944"

\$ 1944 Resurvey B.T. as follows -

26" Now 27" R. Cedar S. 33° W. 15 $\frac{3}{4}$ ft.

BURNED face - NO scribe fd. - nearly Dead.

No Trace N.E. B.T. due probably to old
cat logging. We MK. New B.T.s -

18" I. Cedar N. 36° E. 49 $\frac{1}{4}$ ft.

Mkd. " $\frac{1}{4}$ 520 CS BT"

20" Red Cedar S. 35° W. 36 $\frac{3}{4}$ ft.

Mkd. " $\frac{1}{4}$ 529 CS BT"

27" Red Cedar S. 33° W. 15 $\frac{3}{4}$ ft.

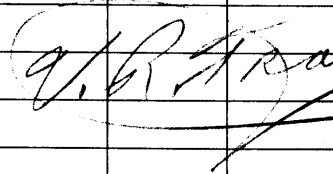
(1943 BT) Mkd. " $\frac{1}{4}$ 529 CS BT"

This cor. Lies on nearly E-W,
cutting line - cutoff to North, also

There is steel fence post along side BRASS cap.

July 11, 1966

V.R.T.
J.H.

 FILED
RECEIVED

JUL 11 1966

COUNTY SURVEYOR
DOUGLAS COUNTY, ORE.

V.O.N. J.W.B.

*#73

C.S. File No. 54-27-29