

Renew Sec. COR. ^{53 | 52} 510 | 511 T255 R3W

Fd. G.L.O. BRASS Cap MKd. "T255 R3W ^{53 | 52} 510 | 511

1943 " with steel fence Post set along side
& B.T.s as follows -

ORIG. 36" FIR N. 55° E, 13 $\frac{1}{2}$ Ft.

Now SHATTERED blow down - lying face down

ORIG. 48" Now 50" FIR S. 51° W, 7 $\frac{1}{2}$

Now BURNED STUMP - NO SCRIBE.

1943 Resurvey 10" Now 11" FIR S. 40° E, 73 $\frac{1}{2}$ ft.

Now badly BURNED STUMP - NO SCRIBE.

1943 Resurvey 8" Now 11" FIR N. 38° W, 19 $\frac{1}{2}$ ft.

6° ft. high SNZY - shows very good SCAR
we do not open - to preserve scribe.

we M.K. only available trees -

3" chinquapin S. 7 $\frac{1}{2}$ ° W, 40 $\frac{3}{4}$ ft.

Mkd. "510 CS BT"

3" Laurel N. 84° E, 18 $\frac{1}{2}$ ft.

Mkd. "52 CS BT"

This COR. lies on very steep
N.W. slope of R. course West.


FILED

RECEIVED

August 8, 1966

V.R.T.

AUG 28 1966

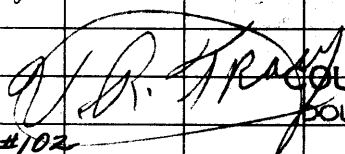

COUNTY SURVEYOR
DOUGLAS COUNTY, ORE.

* #102

C. S. File No. 54 | 27-35