

Review $\frac{1}{4}$ $\frac{58}{517}$ T255 RBW

Fd. G.P. BRASS Cap MKd. " $\frac{1}{4}$ $\frac{58}{517}$ 1944"

with Steel fence post set along side.

1944 B.T.s 25 follows -

20" Now 30" W. FIR N. 3° E, 15 $\frac{3}{4}$ ft.

2 live shows good scar - we don't open.

20" Now 25" W. FIR S. 25° E, 29 $\frac{3}{4}$ ft.

Now 5 N 29 - shows good scar - we don't open.

MARK New B.T.s -

18" Yew S 25° W, 26 $\frac{4}{4}$ ft.

Mkd. " $\frac{1}{4}$ 517 CS BT"


12" R. cedar N. 12° E, 18 $\frac{3}{4}$ ft.

Mkd. " $\frac{1}{4}$ 58 CS BT"

COR. Lies on Gentle NE. Slope.

August 17, 1966

V.P.T.
J.H.

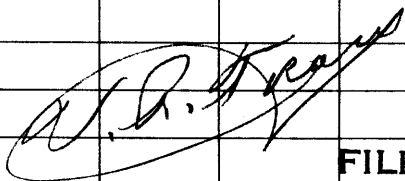

FILED

RECEIVED

AUG 17 1966

COUNTY SURVEYOR
DOUGLAS COUNTY, ORE.

C.S. File No. 54/27-44

* #111