


Review $\frac{1}{4}$ 521/522 T255 R3W
Fd. GLO. BRASS Cap in Mound of
STONE MKd. " $\frac{1}{4}$ 521/522 1943" with
Steel Fence Post along side of
Stump of one B.T. as follows -
1943 BT - 32" Now 34" Fir N. 59° E. 31⁰ ft.
Shows " $\frac{1}{4}$ 5 BT" scribe on partially
healed blaze. Now STUMP. No
Trace N. W. B.T. - MK. New BTs -
10" Hemlock N. 18° E. 25⁸ ft.
MKd. " $\frac{1}{4}$ 5 22 CS BT"
11" Hemlock N. 70° W. 62⁷ ft.
MKd. " $\frac{1}{4}$ 521 CS BT"

August 18, 1966

V.R. ST
J.H.
F.J.
T.C.

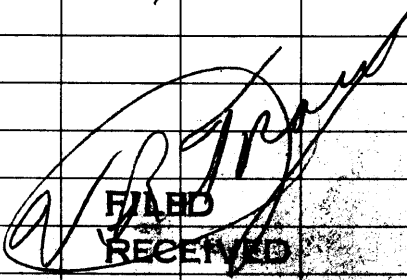

FILED
RECEIVED

AUG 18 1966

COUNTY SURVEYOR
DOUGLAS COUNTY, ORE.

* #114

C.S. File No. 54/27-47