

Review  $\frac{1}{4}$  520/521 T255 R3W

Fd. G. 40. BRASS cap MKd.  $\frac{1}{4}$  520/521

1943" Bent over & steel fence post  
Set along side we Reset BRASS cap  
in proper position in mound of stone.  
find one B.T. STAMP.

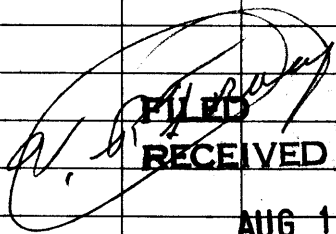
64" FIR S. 75  $\frac{1}{2}$ ° E. 37  $\frac{6}{8}$  FT.  
shows " $\frac{1}{4}$  521 BT" scribe on unhealed  
blaze - now STAMP. Also find possible  
STAMP of B.T. to NW, cut too low for  
scribe. MARK new B.T.s.

5" D. FIR S. 63° W. 48  $\frac{8}{8}$  FT  
MKd. " $\frac{1}{4}$  520 CS BT

5" D. FIR S. 85° E. 28  $\frac{6}{8}$  FT.  
MKd. " $\frac{1}{4}$  521 CS BT "

August 18, 1966

V.R.T.  
J.H.  
E.J.  
T.C.

  
**FILED**  
**RECEIVED**

AUG 18 1966

**COUNTY SURVEYOR**  
**DOUGLAS COUNTY, ORE.**

\*116

G.S. No. 54/27

-48