

Renew Sec. Cor. ^{59 | 510} 516 | 515 T255 R3W

Fd. G.L.O. BR255 Cap. MKd. T255 R3W

^{59 | 510} 516 | 515 1943" with steel fence Post

Set along side & one 1943 Resurvey

BT. 2 live & intact, as follows -

14" Now 20" Hemlock S. 88 1/4 ° E. 66 ft.

shows partial scribe on nearly healed blaze.

All other Bts destroyed by Logging - Now

Stumps - Turnouts - etc. We MK. New Bts -

12" Hemlock S. 75 ° W. 60 7 ft.

Mkd. T255 R3W S 16 CS BT"

6" Hemlock N. 56 ° W. 33 5 ft.

Mkd. S 9 CS BT"

8" D. Fir N. 41 ° E. 48 6 ft.

Mkd. S 10 CS BT


Cor. lies approx 375 ft East of

Creek course N on Flat Bench.

August 4, 1966

U.R.T.
J.B.
J.H.

FILED
RECEIVED

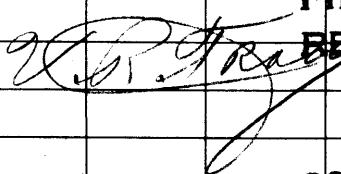

AUG 4 1966

COUNTY SURVEYOR

* #90
O.K. J.W.B.

DOUGLAS COUNTY, ORE.
C.S. File No. 53/27-51