

Renew $\frac{1}{4} \frac{56}{57}$ T255 R3W

Fd. G20, BRASS Cap MKd. " $\frac{1}{4} \frac{56}{57}$ 1944"

\$ B.T.s as follows -

ORIG. 20" Now 24" FIR S. $81\frac{1}{2}^{\circ}$ W. 9 $\frac{1}{2}$ ft.
partial scribe visible on chopped out
blaze. alive.

1944 Resurvey 46" Now 48" FIR S. $23\frac{1}{2}^{\circ}$ W. 30 $\frac{1}{2}$ ft.

Blaze pitched over - no scribe visible.

ORIG. NW. B.T. Now NEAR ROTTED AWAY - NO
scribe Fd. & 1944 BT TO NW. Now
STUMP with pitched face. we MK New
BT -

22" I. cedar N. $29\frac{1}{2}^{\circ}$ W. 45 $\frac{1}{2}$ ft.


Mkd. " $\frac{1}{4}$ 56 55 BT"

COR. Lies on moderate S.W. slope
APPROX 470 FT. East of CREEK
COURSE N. W.

August 22, 1966

V.R.T.
J.H.

FILED
RECEIVED

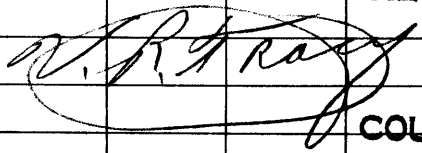

AUG 22 1966

COUNTY SURVEYOR
DOUGLAS COUNTY, ORE.

0 119

G.S. File No. 54/27-3