

Renew $\frac{1}{4}$ 510/511 T245 R3W

Fd. 2" x 20" steel pipe - Bent & Burned
& B.T.s as follows -

ORIG. 72" FIR East 92 ft,

NOW BURNED STUMP - NO SCRIBE - we
Rescribe " $\frac{1}{4}$ 511 65 BT "

ORIG. 8" now 14" Cedar N. 50° W. 19 1/2 ft.

NOW STUMP - BURNED - we open & find
" $\frac{1}{4}$ " Reverse. Weyerhaeuser
Method B.T. (see Ren. #41)

55" FIR N. 53° W. 35 1/2 ft.

NOW STUMP - "W" Nail & Tag, SW "W"
B.T. destroyed. Set 1" IP. & BRASS


22R MKD. COUNTY SURVEYORS
OFFICE 1967 T245 $\frac{1}{4}$ 510/511 R3W"

In place of old pipe & set 6 ft.
Steel fence post along side.

No other suitable trees or stumps
available. This area was clearcut
& burned this year.

Dec 1, 1967

V.R.T.
J.H.
V.P.

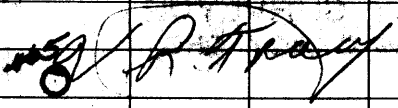

w.k. J.W.G.

C. S. File No. 53/22

96