

Renew $\frac{1}{4}$ $\frac{57}{576}$ T 2 S R 2 W

Fd. 1962 cad. BRASS cap, properly mKd.
& B.T.s as follows -

ORIG. 32" Now 33" Fir N, 27° E, 2⁶ ft,
alive - shows good scar - does not open.

ORIG. Broken Hemlock stump 7" diam.
S, 30° W, 4⁰ ft. with "4" scribe

visible. we find NO Trace of B.T.
mKd. in 1962 - Due to Logging. mK.


New B.T. -

8" Hemlock S, 6 $\frac{1}{2}$ ° E, 75³ ft,
mKd. "1/4 5 16 CS BT"

This cor. lies on S.W. slope
in logged off unit.

March 20, 1967

U.R.T.
J.H.
D.W.

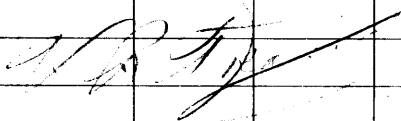

FILED
RECEIVED

MAR 20 1967

COUNTY SURVEYOR
DOUGLAS COUNTY, ORE.

C. S. File No. 54/27/20

✓
77
* O.W. J.W.D.