

Renew $\frac{1}{4}$ 530 T255 R2W & R3W

Fd. G.L.O. BRASS Cap MKd. " $\frac{1}{4}$ 53 1943"

& BT's MKd. in 1943 as follows —

24" Now 24" Fir N. 49° E. 87 $\frac{8}{8}$ ft.

Down & out of place - scribe visible on
Burned face.

30" Now 57" Fir S. 43° E. 104 $\frac{2}{2}$ ft.

- face BURNED - scribe barely visible

Rescribe " $\frac{1}{4}$ 5 CS" This Tree is

Almost dead - we MK. New BT's —

12" D. Fir N. 44° E. 87 $\frac{2}{2}$ ft.

Mkd. " $\frac{1}{4}$ 530 CS BT"

4" Pine S. 12° E. 75 $\frac{5}{5}$ ft.

Mkd. " $\frac{1}{4}$ 5 BT" (only)

This cor. lies on N.W. edge of small
clearing approx 150 X 300 ft. on S.
slope.

June 27, 1966

V.R.T


FILED

J.B.

RECEIVED

J.H.

JUN 27 1966

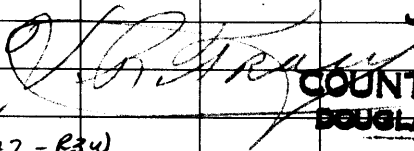

COUNTY SURVEYOR

DOUGLAS COUNTY, ORE

#47 - R3W

* #64

O.K. J.W.B. C.S. File No. 54/27-169