


Renew $\frac{1}{4}$ S 1/4 T25S R3W & R2W
Ed. G.L.O. BRASS CAP MKD. " $\frac{1}{4}$ 51/1943"
Bent over - we straighten & Reset in
MOUND of stone - NW. B.T. GONE.
Stumps of S.E. & S.W. B.T.s REMAIN.
we MK. New B.T. -
12" Fir (SNAG 15 ft. high) N. 73° W
39' ft. - MKD. " $\frac{1}{4}$ 51 CS BT"
No Live Trees Available - COR.
Lies on very steep N. slope
10 ft. North of Rock face
5' ft High x 25' ft Long
course E. & W.

July 29, 1966

U.R.T.
J.B.
J.H.

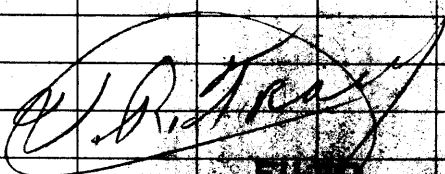

FIELD
RECEIVED

JUL 29 1966

#69-125-2
#70-125-3

COUNTY SURVEYOR
DOUGLAS COUNTY, ORE.

K.O.K. J.W.B.

C.S.P. 22-17