

Renew S.E. Cor 536 | T235 R3W

Fd. 1/2" I.P. "W" method B.T. 25 Recorded
in CS File 53\107 & O.B.T. 25 follows
Orig 26" Now 42" F, R N, 45° W. 8⁶ ft.
Now stump - old BARK scribe visible
in poor cond. - also "W" nail

"W" B.T. - 40" FIR STUMP N, 47° E, 13⁷ ft.

"W" Nail & T29. - in place of 1/2" IP
at cor set 1" IP & BRASS CAP MKD.

"COUNTY SURVEYOR'S OFFICE 1968

T235 R3W 536 | T245 R2W "Reset. I.P.

along side BRASS CAP & MK. New B.T. -

60" FIR STUMP N, 47° W, 26¹ ft.

MKD. "T235 R3W 536 CS BT"


This cor. lies on S.E. Slope
on top of cut BANK of old cat Road.
in logged off area.

April 1, 1968

V. R.T.

J.H.

I.P.

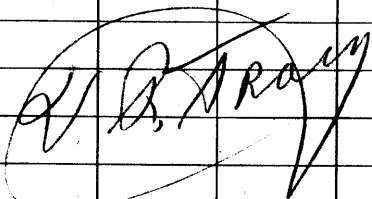

49-T23-6

458-T23-3

472-T24-3

445-T24-2

W. J. W. B.

C. S. File No. 53/27-220