

Renew Sec. COR. $\frac{52}{511} | \frac{51}{512}$ T245 R2w

Fd. O.B.T.s as follows -

orig. 24" Now 30" FIR N, 66° E, 27 $\frac{3}{4}$ ft.

live - shows good SCAR - Record N, 60° E, -

orig. 16" Now 17" FIR S, 31° E, 4 $\frac{6}{8}$ ft,

Now 5 ft. high STUB - scribe visible

orig. 6" pine S, 45° W, 7 $\frac{2}{8}$ ft,

Down & Blaze Badly decayed.

orig. 24" Now 28" FIR N, $18\frac{1}{2}^{\circ}$ W, 29 $\frac{2}{8}$ ft.

live - very good SCAR. - at cor

point set 1" I.P. & BRASS cap MKd.

"COUNTY SURVEYOR'S OFFICE

1969 T245 $\frac{52}{511} | \frac{51}{512}$ R2w" &

MK. New B.T.s -

26" D. FIR S, 1° W, 11 $\frac{7}{8}$ ft.

MKd. "T245 R2w S11 CS BT"


26" Hemlock S, 53° E, 27 $\frac{3}{8}$ ft.

MKd. "T245 R2w S12 CS BT"

COR. lie on moderate SE. slope
in dense Rhododendron brush.

August 28, 1969

V.R.T.
J.G.H.
V.D.P.
F.W.J.

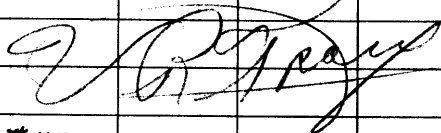

#73

C.S. File No. 5

o.k.
V.W.G.
-261