

Renewal

$\frac{S2}{S11}$

T31S R2W

Found

29" Fir NOW 31" N71W 15°

opened for scribbing "1" S"

10" Fir NOW stump S36E 29°

No scribbing found on this stump

Renewed:

Set Brass cap at $\frac{1}{4}$ cor M&D,

County Surveyors office

T31S R2W

$\frac{1}{4}$ $\frac{S2}{S11}$


A66

New Bearing Tree

9" D. Fir S27W 25°

Scribbed $\frac{1}{4}$ S11 c.s. BT

This cap lies 2° North of E-W
Fence line $\pm 12^{\circ}$ East of Fence
corner B-15-16

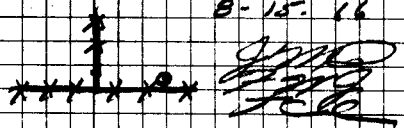

(Renewal #5)

*B100-

C.S. No. No. 54/28-77

DIETZGEN NO. 385-6