

Renewal

9  
10

T313 R9W

Found:

3/4" Iron Pipe Bent over & Buried  
in skid Rd. This pipe set 1958  
CS File 54/178 MP 20-16, Ren. #21

Also unrecovered scribed stump  
S 57 1/2 E 24 E scribed BT 1/2  
No trace of orig BT's. Logged &  
burnt

using Iron pipe & scribed stump  
bearing & dist from Tag. I renewed  
Set Brass cap along side Iron  
pipe N 50.


county surveyors office  
T313 R9W

1/4 59  
516  
1970

New Bearing objects

3/8" I Rod at Base of 12" R stump N 25 W 20'

3/8" I Rod at Base of 4" R stump S 60 W 22'

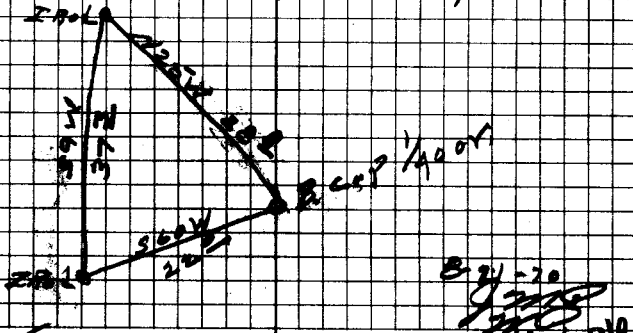

821-20  
220  
270

4154

C.S. File No. 54/32-96

DIETZGEN NO. 385-6