


T-31S., R-10W., W.M.

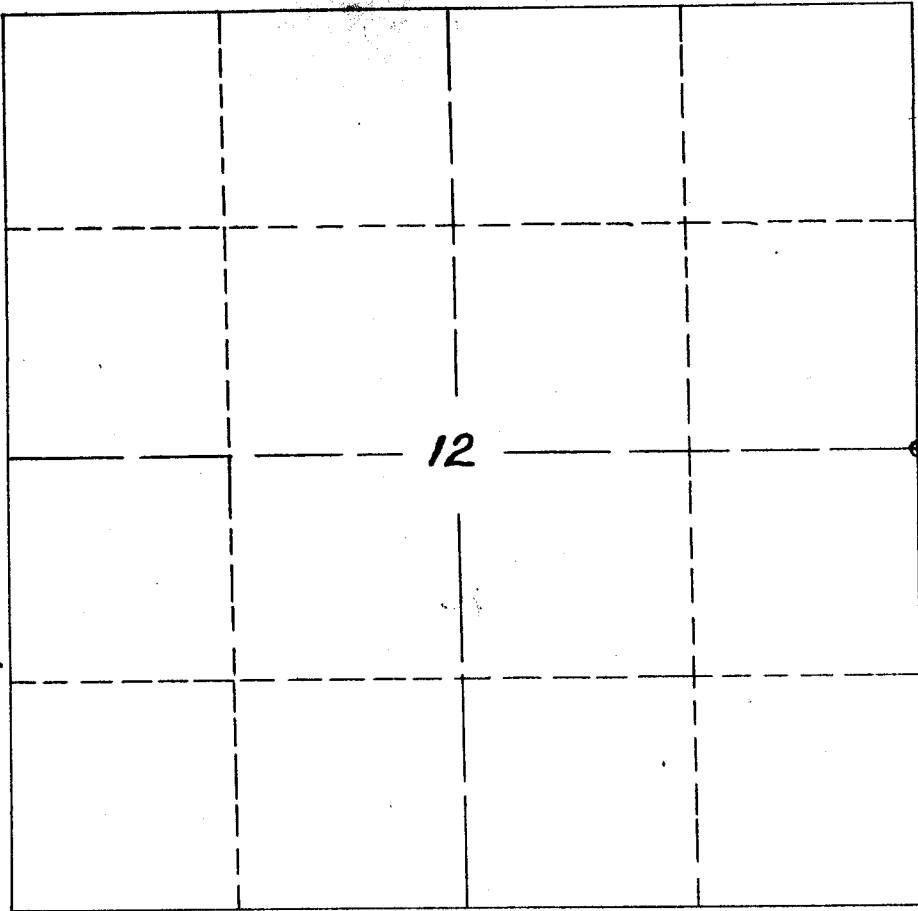


Filed March 8, 1955 J. M. Herdman Coos County Surveyor

Survey for the Coos Bay Lumber Company, Coos Bay, Oregon,
by C.S. Lehmanowsky August 27, 1954.

I marked new B.T. for the east 1/4 Corner Section 12, T-31S.,
R-10W., W.M. Original Corner rock in place; original B.T.s
destroyed by logging operations and fire. For this Corner I
marked 72 in. Fir, S73°00'W, distance 33.0 ft.

• Corner found.

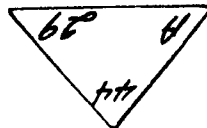

C.S. Lehmanowsky
Surveyor

10-113

See Rem. #137, T31-9W