


FILED  
RECEIVED

FEB 1 1967

COUNTY SURVEYOR  
DOUGLAS COUNTY, ORE.

Note:-  
Bearing shown are from Co. Surv. File 40-104 and  
45-201

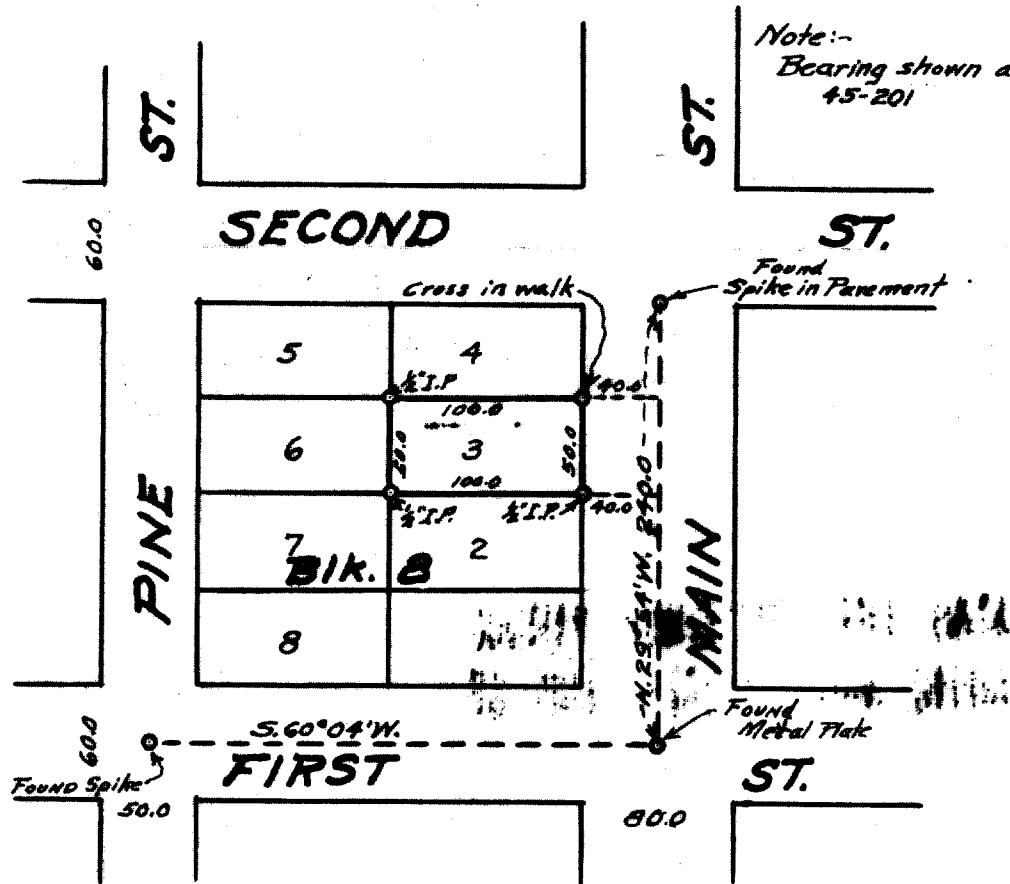

COUNTY SURVEYOR'S OFFICE  
DOUGLAS COUNTY, OREGON.

SURVEY OF LOT 3 BIK. 8, CITY OF  
CANYONVILLE, FOR CLYDE MARRIOTT.  
GEO. J. WENDEROTH, DEPUTY. JAN. 1967

Scale 1" = 100 ft.

DO NOT REMOVE FROM OFFICE

REGISTERED  
OREGON  
LAND SURVEYOR

*Geo. J. Wenderoth*

MARCH 19, 1944  
George J. Wenderoth  
5

C. S. File No. 4

T. 30 - 5 SEC. 34