

Revised $\frac{1}{4}$ $\frac{531}{56}$ T265 R2W
T275

Ed. notes as follows -

orig. 24" now 33" Fir N. 78° E. 49 $\frac{5}{8}$ ft.
alive - shows good scar - we cannot open.
Bearing should be N. 75° E.

orig. 24" now 36" Fir S. 8° E. 26 $\frac{4}{8}$ ft.
Now sowed stump - bearing should be
S. 12° E. - we open & find "56 BT"

scribe & reverse under 41 years
of overgrowth - these B.T.s were
apparently rescribed about 1913
during the last retracement of
the S. line of 26-2. set 1" I.P.

& BRASS CAP MKD. "COUNTY SURVEYORS
OFFICE 1967 T265 $\frac{1}{4}$ $\frac{531}{56}$ T275

R2W" & MK. New B.T.s -

17" cedar S. 85° E. 83 $\frac{8}{8}$ ft.

Mkd. $\frac{1}{4}$ 56 CS BT"

10" cedar N. 23° E. 29 $\frac{3}{8}$ ft.

Mkd. $\frac{1}{4}$ 531 CS BT"

This cor. lies on E-W. cutting
line - cutoff to South approx. 10 to 15
years ago.

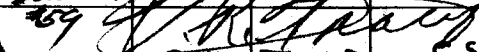
UAT.

J.H.

D.W.

July 10, 1967

#62-T27-2

59 

O.K. J.W.B.

C.S. File No. 54/20-11