

Review $\frac{1}{4}$ $\frac{520}{529}$ T265 R2W

Fd. O.B.T.s 25 follows -

orig. 10" Now 22" cedar N 21° E, 15 $\frac{8}{8}$ ft.

Now down & Burned - No scribe fd.

orig. 8" Now 16" Fir S. 38° E, 7 2 ft.

Now SN 29. we open & fd. " $\frac{1}{4}$ S "

scribe & Reverse. 2/50 Find

unrecorded $\frac{3}{4}$ " I.R. which bears

S 4 $\frac{1}{2}$ ° E, 9 $\frac{6}{6}$ ft FROM TR 4 COR.

Set 1" I.P. & BRASS CAP MKD "COUNTY

SURVEYOR'S OFFICE 1967

T265 $\frac{1}{4}$ $\frac{520}{529}$ R2W " & MK. New B.T.s -

9" D. Fir N. 56° W, 47 $\frac{8}{8}$ ft.

Mkd. " $\frac{1}{4}$ S 20 CS BT "

15" cedar S. 33° W, 94 $\frac{2}{2}$ ft.

Mkd. " $\frac{1}{4}$ S 29 CS BT "

This COR. Lies in Logged off

area grown up to Dense

greasewood BRUSH on gentle

S.E. slope. approx 200 ft E.


of Log Road.

July 11, 1967

U.R.T.

J.H.

D.W.

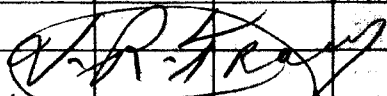

#44 O.K.J.W.B.

C.S.F.

10-13