

Renew $\frac{1}{4}$ $\frac{532}{55}$ T265 R2W

Fd. O.B.T.s 25 Follows -

ORIG. 20" Now 22" Laurel N. 35° W. 4 $\frac{1}{2}$ ft.

2 live - scribe visible on unhealed Bl 22 e.

ORIG. 20" Now 32" Fir S. 35° E. 19 $\frac{1}{2}$ ft.

2 live - BARK scribe " $\frac{1}{4}$ B " in fair

COND. Set 1" I.P. & BRASS CAP MKd.

COUNTY SURVEYOR'S OFFICE 1967

T265 $\frac{1}{4}$ $\frac{532}{55}$ T275 R2W " & MK. New B.T.

12" D. Fir N. 8° W. 12 $\frac{8}{8}$ ft.

Mkd. " $\frac{1}{4}$ 532 CS BT "


20" W. Fir S. 1° W. 9° ft.

Mkd. " $\frac{1}{4}$ 55 CS BT "

This cor. lies on Top of Ridge
Sloping South & on E-W. cutting
Line - cutoff to North -

July 26, 1967

U.R.T.
J.H.
D.W.

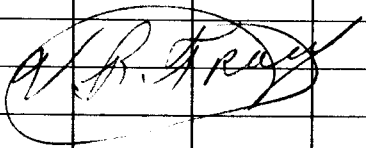

#66-T27-2

#60

O.K. J.W.B.

C.S. File No. 54/40-33