

Renew Closing Cor. R2W $\frac{530}{531}$ T265 RIW

Fd. O.B.T. 25 follows -

8" Now 16" Hemlock S. 27° E. 15² Ft.

alive - open & find "RIW 531 CC BT"

scribe - No TRACE NE, BT, OR COR.

STONE - Set 1" I.P. & BRASS CAP MKD.

"COUNTY SURVEYORS OFFICE 1967

T265 R2W $\frac{530}{531}$ RIW " & MK. New

BT'S -

44" D. FIR N. 40° E. 32° Ft.

Mkd. "T265 RIW 530 CC CS BT"

14" Hemlock S. 32° E. 34² Ft.

Mkd. "T265 RIW 531 CC CS BT"


This cor. Lies on N. Side of

DRY CREEK Bottom course west.

curving S.W.

August 3, 1967

J.R.M.
J.H.
D.W.

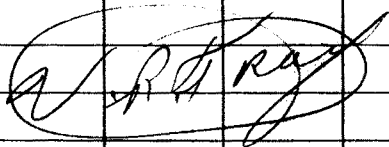

#15-T26-1

#70

O.K. J.W. B.

C.S. File No. 54/40-47